







No.	Issue	Date
1	VILLAGE OF ALMA APPROVAL	MARCH 2017
2	VILLAGE OF ALMA APPROVAL- REVISED ACCESS ON SITE	MARCH 2018
3		
4		

Notes:

- New 14 lots for seasonal recreational vehicles.
- Each proposed lot is 110m<sup>2</sup>
- Each lot to have a 8"x8"x8" stop block located at the end of the pad.
- Existing 100mm sanitary service extended from the neighbouring property owned by Vista Ridge, at a minimum of 0.5%.
- Water service for the proposed expansion was connected to the neighbouring property owned by Vista Ridge.
- Surface water drainage appears to be retained on the proposed developed area of the site with minimal discharge into an existing drainage ditch following temporary storage water storage within several infiltration trenches.
- Third row of trailer sites was moved to a higher elevation near Shady Lane.
- Current onsite roads for RV trailers was modified by the developer twice from the original plan dated June 5, 2015, once prior to the record drawing prepared in 2017 and a second time in 2017. The recent modifications to the onsite roads were to provide a more suitable RV access. The roads shown on this plan are a representative of what is currently on site as of March 7th, 2018.
- Location of RV access onto Shady Lane approved on site with Village personnel.
- As many of the existing trees adjacent to Forest Drive and Shady Lane were kept. Grass was reportedly planted on the lots outside the vehicle pad.
- Fisher Engineering was not retained to provide full time supervision during construction nor was Fisher Engineering retained to collected record drawing elevations of finalized grades.
- Site visit conducted on March 7th 2018. Visual observations made at that time on existing conditions. Underground infrastructure information was provided by contractor/developer.

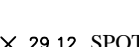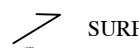
-  SLOPE TO BE STABILIZED WITH RS RIPRAP
-  PROPOSED RECREATIONAL VEHICLE PAD
-  29.12 SPOT ELEVATIONS February 15/12
-  SURFACE WATER DRAINAGE
-  EXISTING AND/OR PROPOSED LOCATION OF TREES
-  SILTATION FENCE




Project Title  
**VISTA RIDGE PROPOSED EXPANSION**  
 PID 05072285  
 ALMA, NEW BRUNSWICK

Drawing Title  
**RECORD DRAWING**  
 VISTA RIDGE CAMPGROUND

Project No. **MR016**  
 Dwg. No. **MR01605RDr2**  
 Scale: **AS NOTED**



Const. North

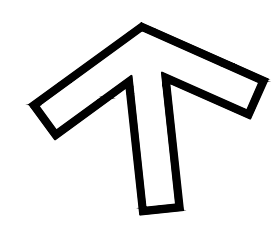


Drawn By: **ACB**

Dwg. Standards Ckd. By:


Designed By: **MJF**

Date Printed

Dwg. Design Ckd. By: **MJF**

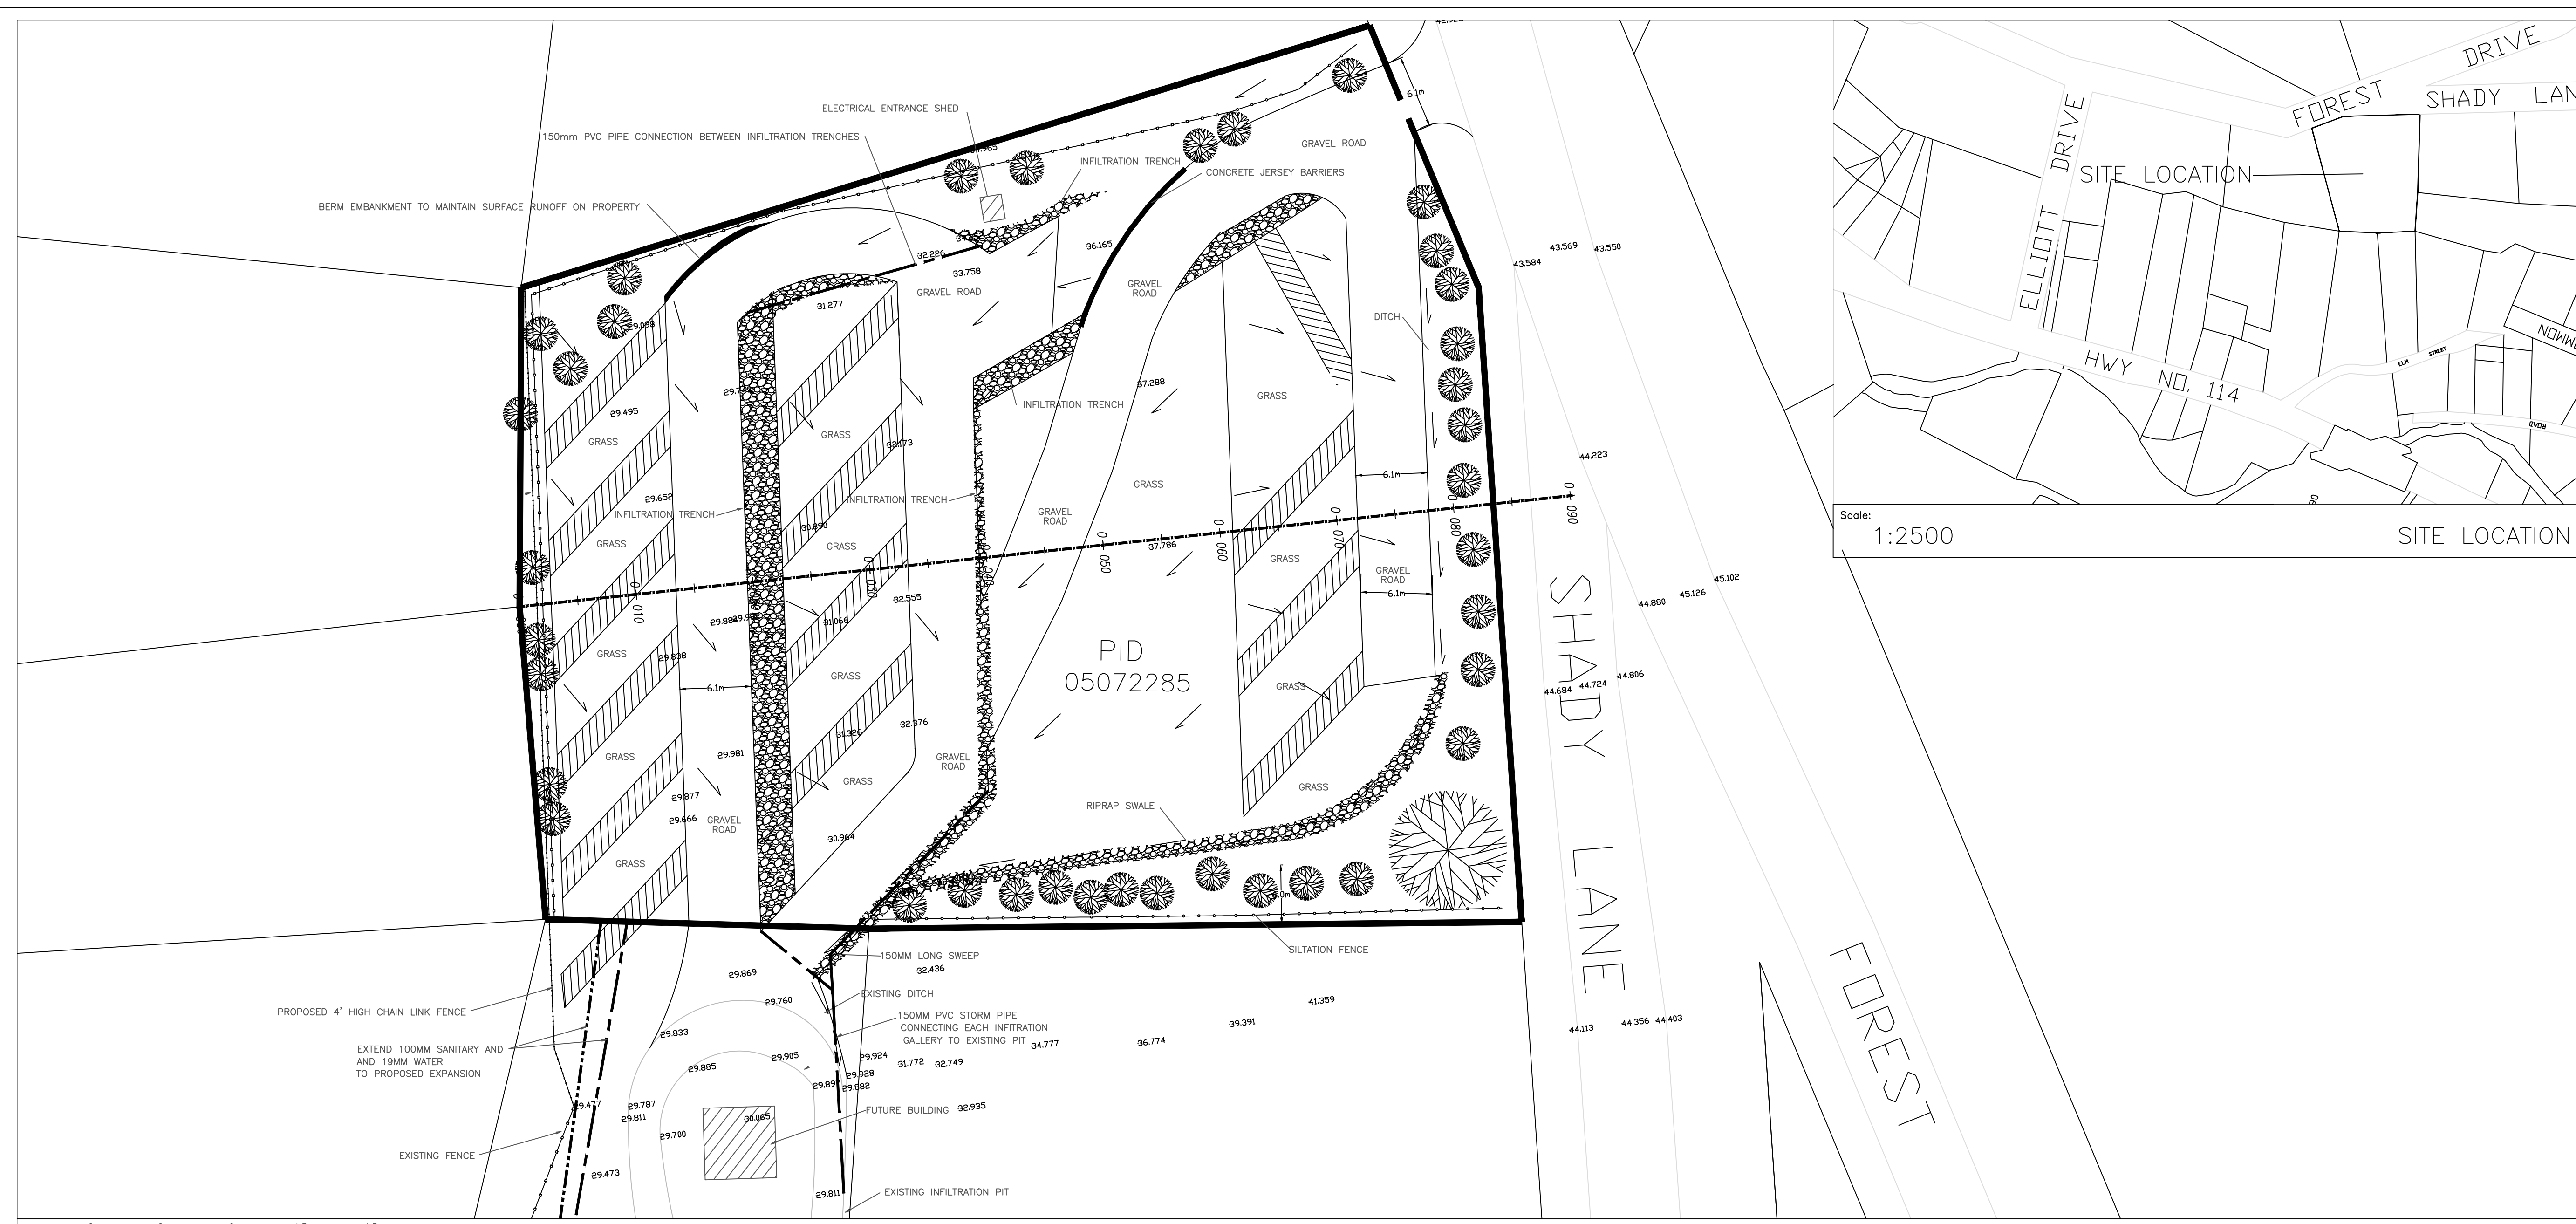

SITE DRAINAGE PLAN

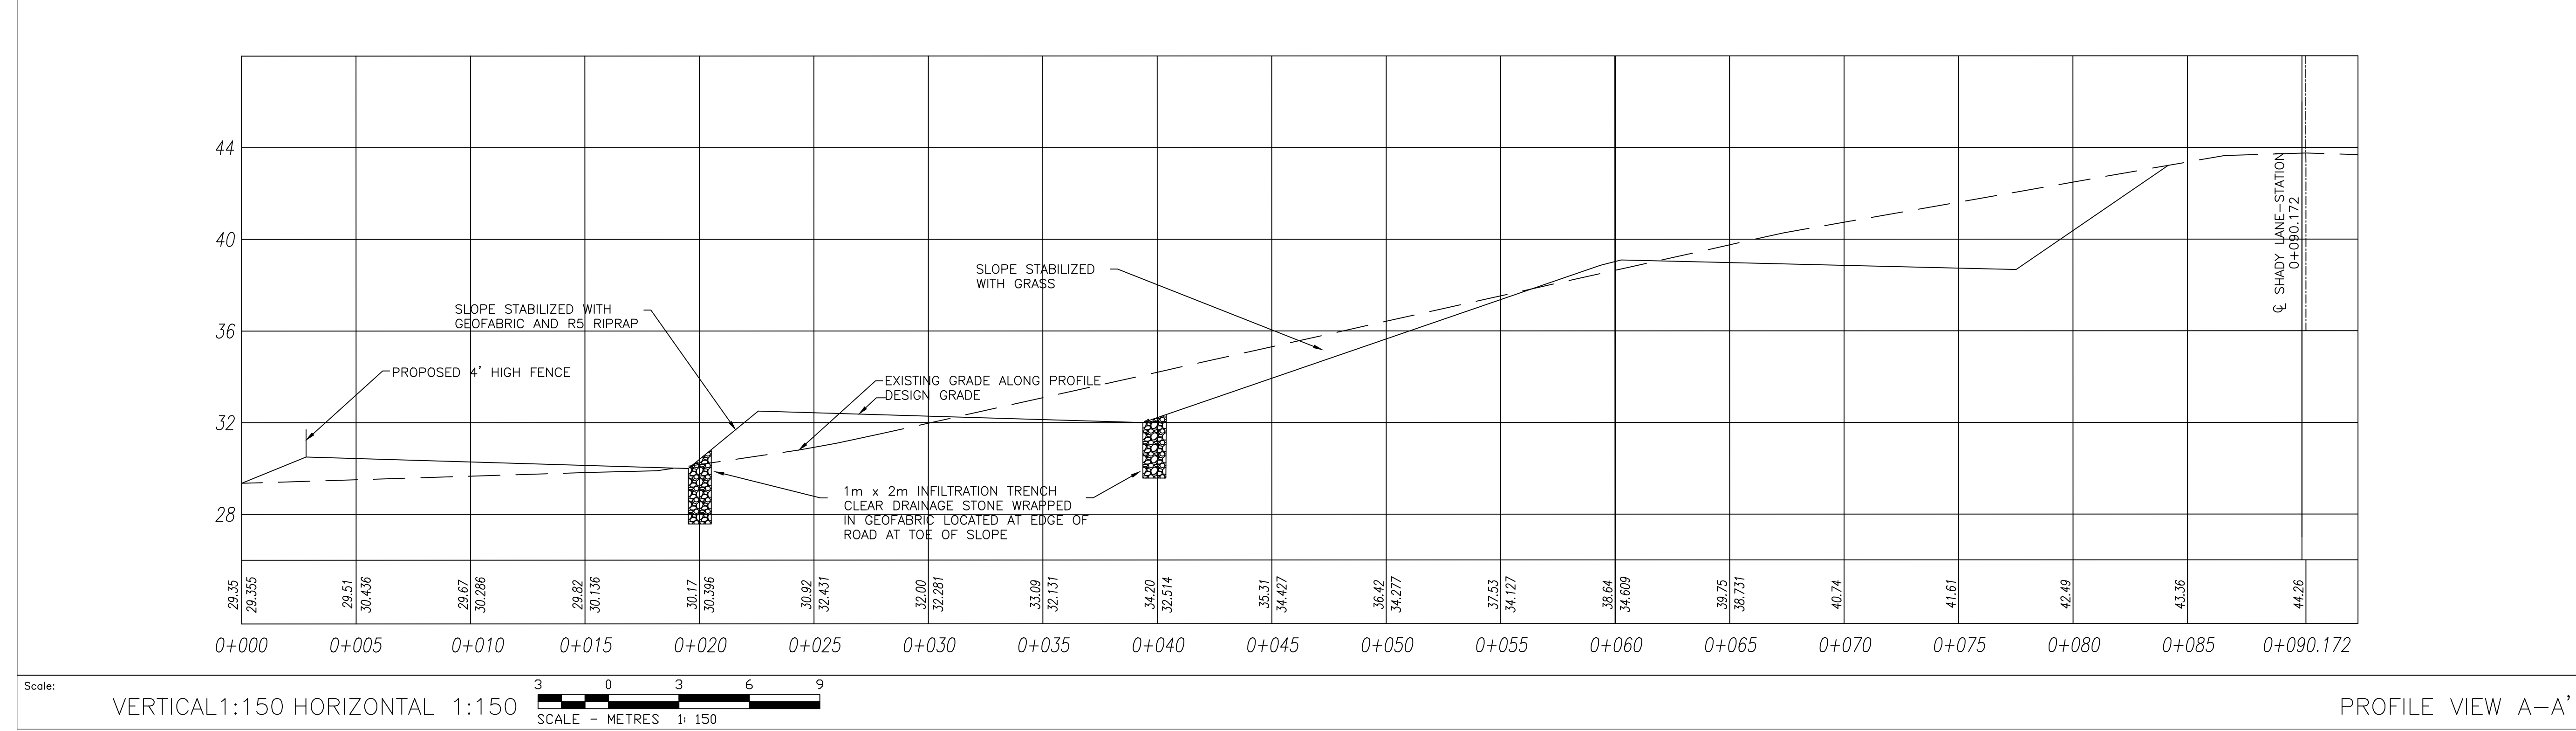

PROFILE VIEW A-A'